

DRAWING NUMBER
H/105
Cantor Fitzgerald
New Corporate Bond Trading Room
105F-5

DRAWING NUMBER
H/105
Cantor Fitzgerald
New Corporate Bond Trading Room
105F-5


DRAWING NUMBER
H/105
Cantor Fitzgerald
New Corporate Bond Trading Room
105F-5

DRAWING NUMBER
H/105
Cantor Fitzgerald
New Corporate Bond Trading Room
105F-5

IF THIS DRAWING IS NOT 24 x 36" IT IS
A REDUCED PRINT SCALE ACCORDINGLY




CHARLES D. FLAYMAN ASSOCIATES INC.
880 CANAL STREET, STAMFORD CT 06902
203 348 4800

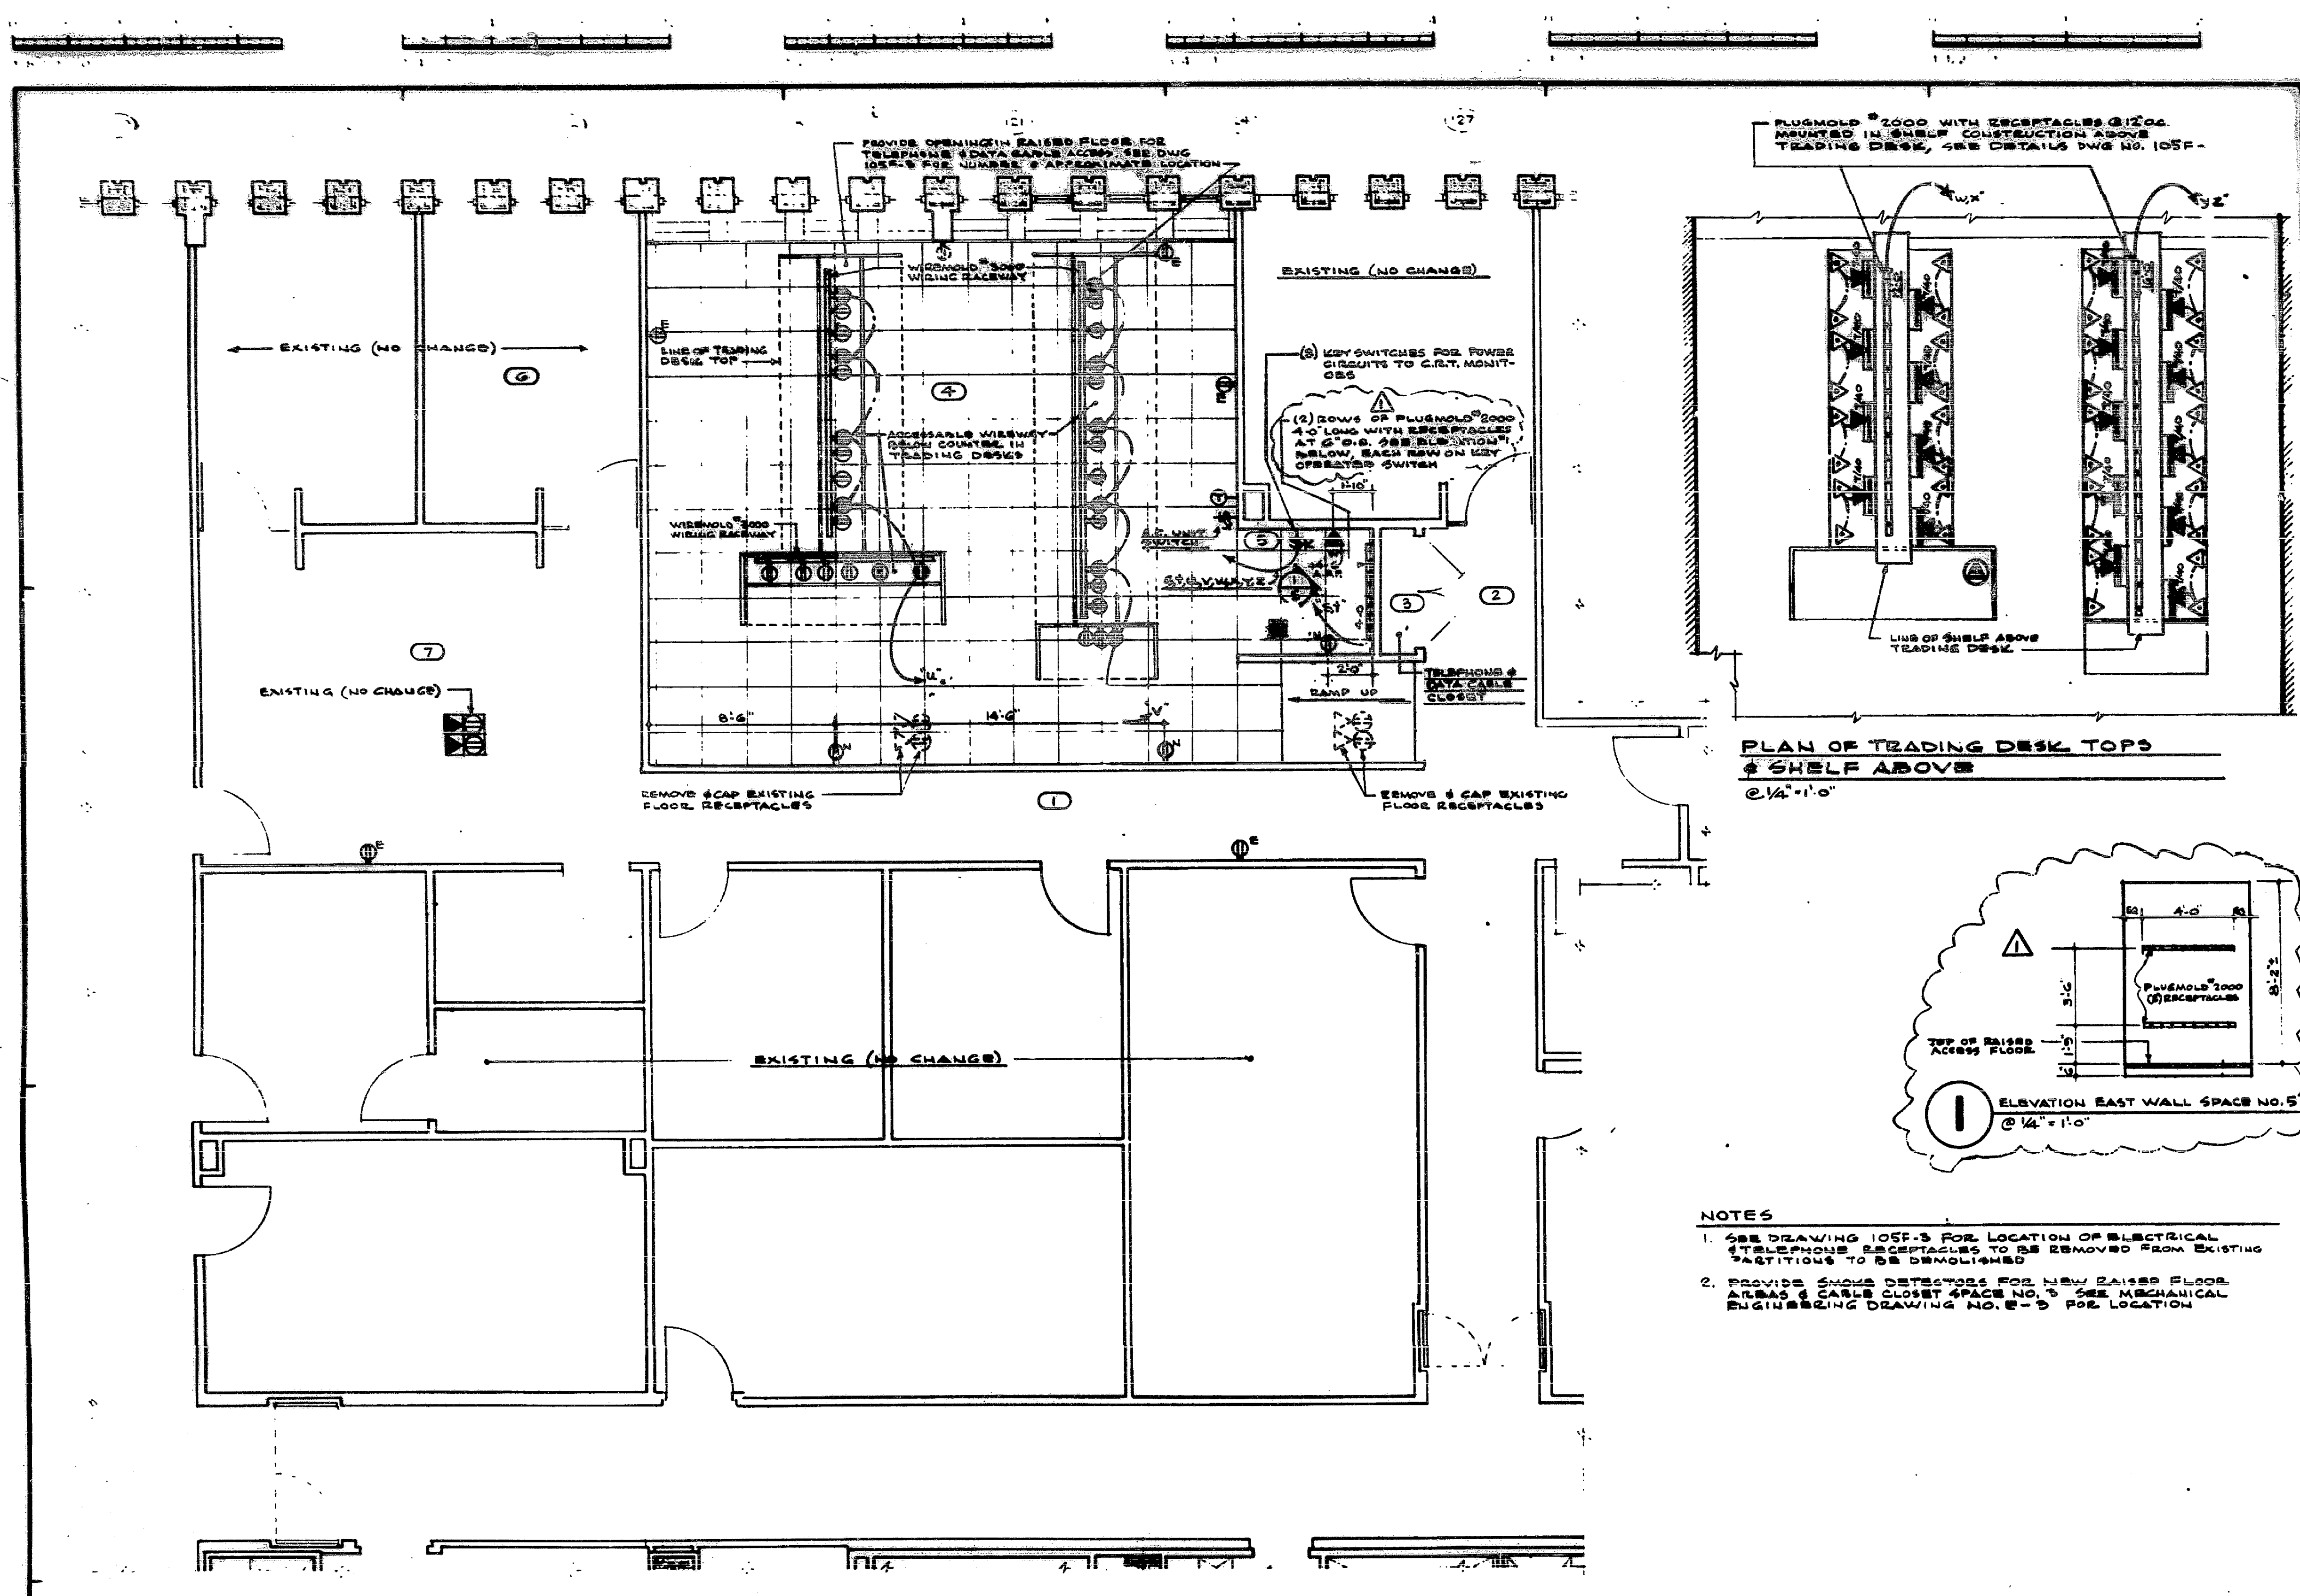

- NOTES
- SEE DRAWING 105F-3 FOR LOCATION OF ELECTRICAL TELEPHONE RECEPTACLES TO BE REMOVED FROM EXISTING PARTITIONS TO BE DEMOLISHED
 - PROVIDE SMOKE DETECTORS FOR NEW RAISED FLOOR AREAS & CABLE CLOSET SPACE NO. 5 SEE MECHANICAL ENGINEERING DRAWING NO. E-5 FOR LOCATION

LEGEND	
	EXIST. WALL OR FLOOR DUPLEX CONVENIENCE RECEPTACLE (NO CHANGE)
	EXIST. WALL OR FLOOR DUPLEX CONVENIENCE RECEPTACLE TO BE REMOVED & CAPPED
	EXIST. FLOOR MOUNTED TELEPHONE RECEPTACLES TO BE REMOVED
	NEW DUPLEX CONVENIENCE WALL RECEPTACLE, SET AT 11'0" ABOVE FINISH FLOOR, UNLESS NOTED OTHERWISE
	NEW DUPLEX CONVENIENCE RECEPTACLE SET IN C/W/OUT IN TRADING DESK AREA
	NEW DUPLEX CONVENIENCE RECEPTACLE ON WIRING RACEWAY INSTALLED IN TRADING DESK WIREWAY
	NEW DUPLEX CONVENIENCE RECEPTACLE ON WIRING RACEWAY KEY SWITCH CONTROLLED FOR C.R.T. MONITORS IN TRADING DESK WIREWAY
	PLUGMOLD 2000, LENGTH & SPACING SHOWN ON PLAN, KEY SWITCH CONTROLLED FOR C.R.T. MONITORS
	NEW DUPLEX CONVENIENCE RECEPTACLE, COVERAGE MOUNTED TO CONC. FLOOR FOR COMMUNICATIONS RACK
	KEY OPERATED SWITCH FOR CONTROL OF RECEPTACLES FOR C.R.T. MONITORS
	40 LINE TELEPHONE TUBEST BUILT IN TO TRADING DESK
	TELEPHONE JACK MOUNTED TO UNDER SIDE OF TRADING DESK TOP PROVIDED INSTALLED BY I.P.C.
	INDICATES LOCATION OF TELEPHONE JACKS, WIRING IS TO BE OPENINGS IN FLOOR & DESK
	OUTLET BOX & PLATE FOR C.R.T. CABLES MOUNT AT HEIGHT SHOWN ON PLAN
	NEW DUPLEX CONVENIENCE RECEPTACLE, KEY SWITCH CONTROLLED FOR C.R.T. MONITORS

THIS DRAWING SHALL BE USED FOR THE LOCATION OF ELECTRICAL TELEPHONE RECEPTACLES ONLY. SEE ELECTRICAL ENGINEERING DRAWING NO. E-5 FOR ALL CIRCUITING PANEL BOARD CONNECTIONS & ELECTRICAL SPECIFICATIONS

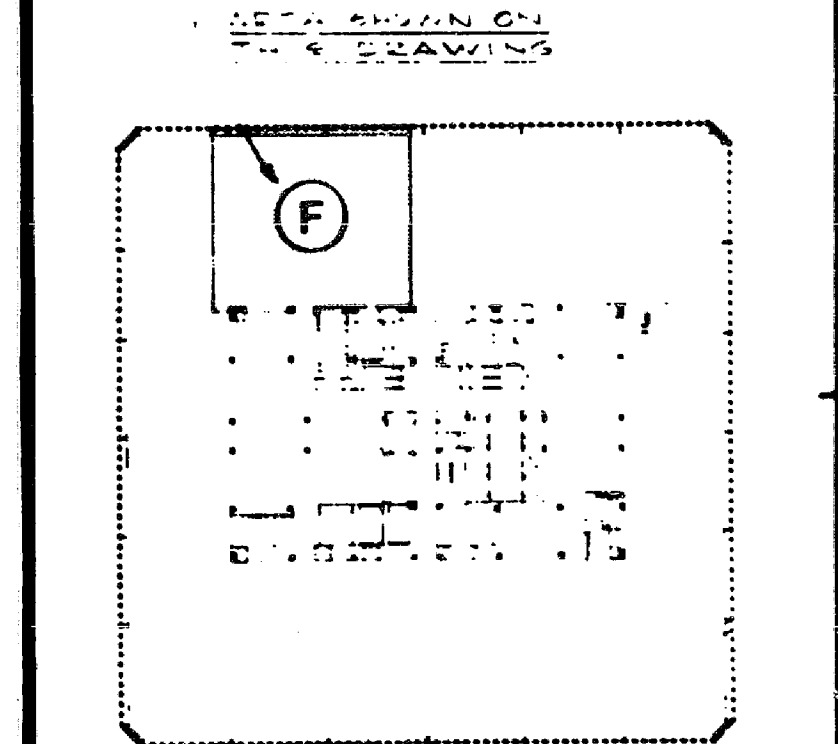



KEY PLAN
1:04 1:0

PHASE
F
TAA NO. 3104
AS BUILT DWG
5-1-85

DATE	ISSUED TO	PR	TR
12-7-84	POST AUTHORITY FOR APPROVAL CIVILS CORP. FOR DISC. C.R.T. FOR RECORDS	3	1
1-18-84	POST AUTHORITY FOR APPROVAL CIVILS CORP. FOR INFORMATION C.R.T. FOR RECORD	10	1
5-9-85	POST AUTHORITY "AS BUILT"	0	2

AS-BUILT DRAWING

DATE 2/6/86
INSPECTOR [Signature]

	4-29-85	GENERAL REVISION TO CONFORM TO AS BUILT CONDITIONS	JFF
	1-11-85	REVISED LENGTH OF PLUGMOLD, ELEV. & PLAN PER P.A. COMMENTS	JFF
NO	DATE	REVISION	BY

CANTOR, FITZGERALD
SECURITIES CORP.
105th FLOOR
ONE WORLD TRADECENTER, NEW YORK N.Y.

NEW CORPORATE BOND
TRADING ROOM
ELECTRIC & TELEPHONE PLAN

	PROJECT NO. 357A
	SCALE 1/4" = 1'-0"
	DRAWN BY J.F.P.
	CHECKED BY
DATE 12-6-84	

DRAWING NO.
105F
5